



1 FIRE ALARM ROOF PLAN
N.T.S

NOTE:


THE CONDUIT FOR THE FIRE ALARM SYSTEM SHALL BE ROUTED AND MOUNTED ON THE UNDERSIDE OF THE DUCT AND THROUGH THE AHU. NO CONDUIT SHALL BE ROOF MOUNTED.

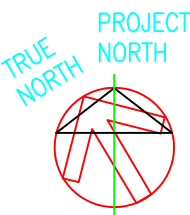

2 VESDA PIPING ISOMETRIC
N.T.S

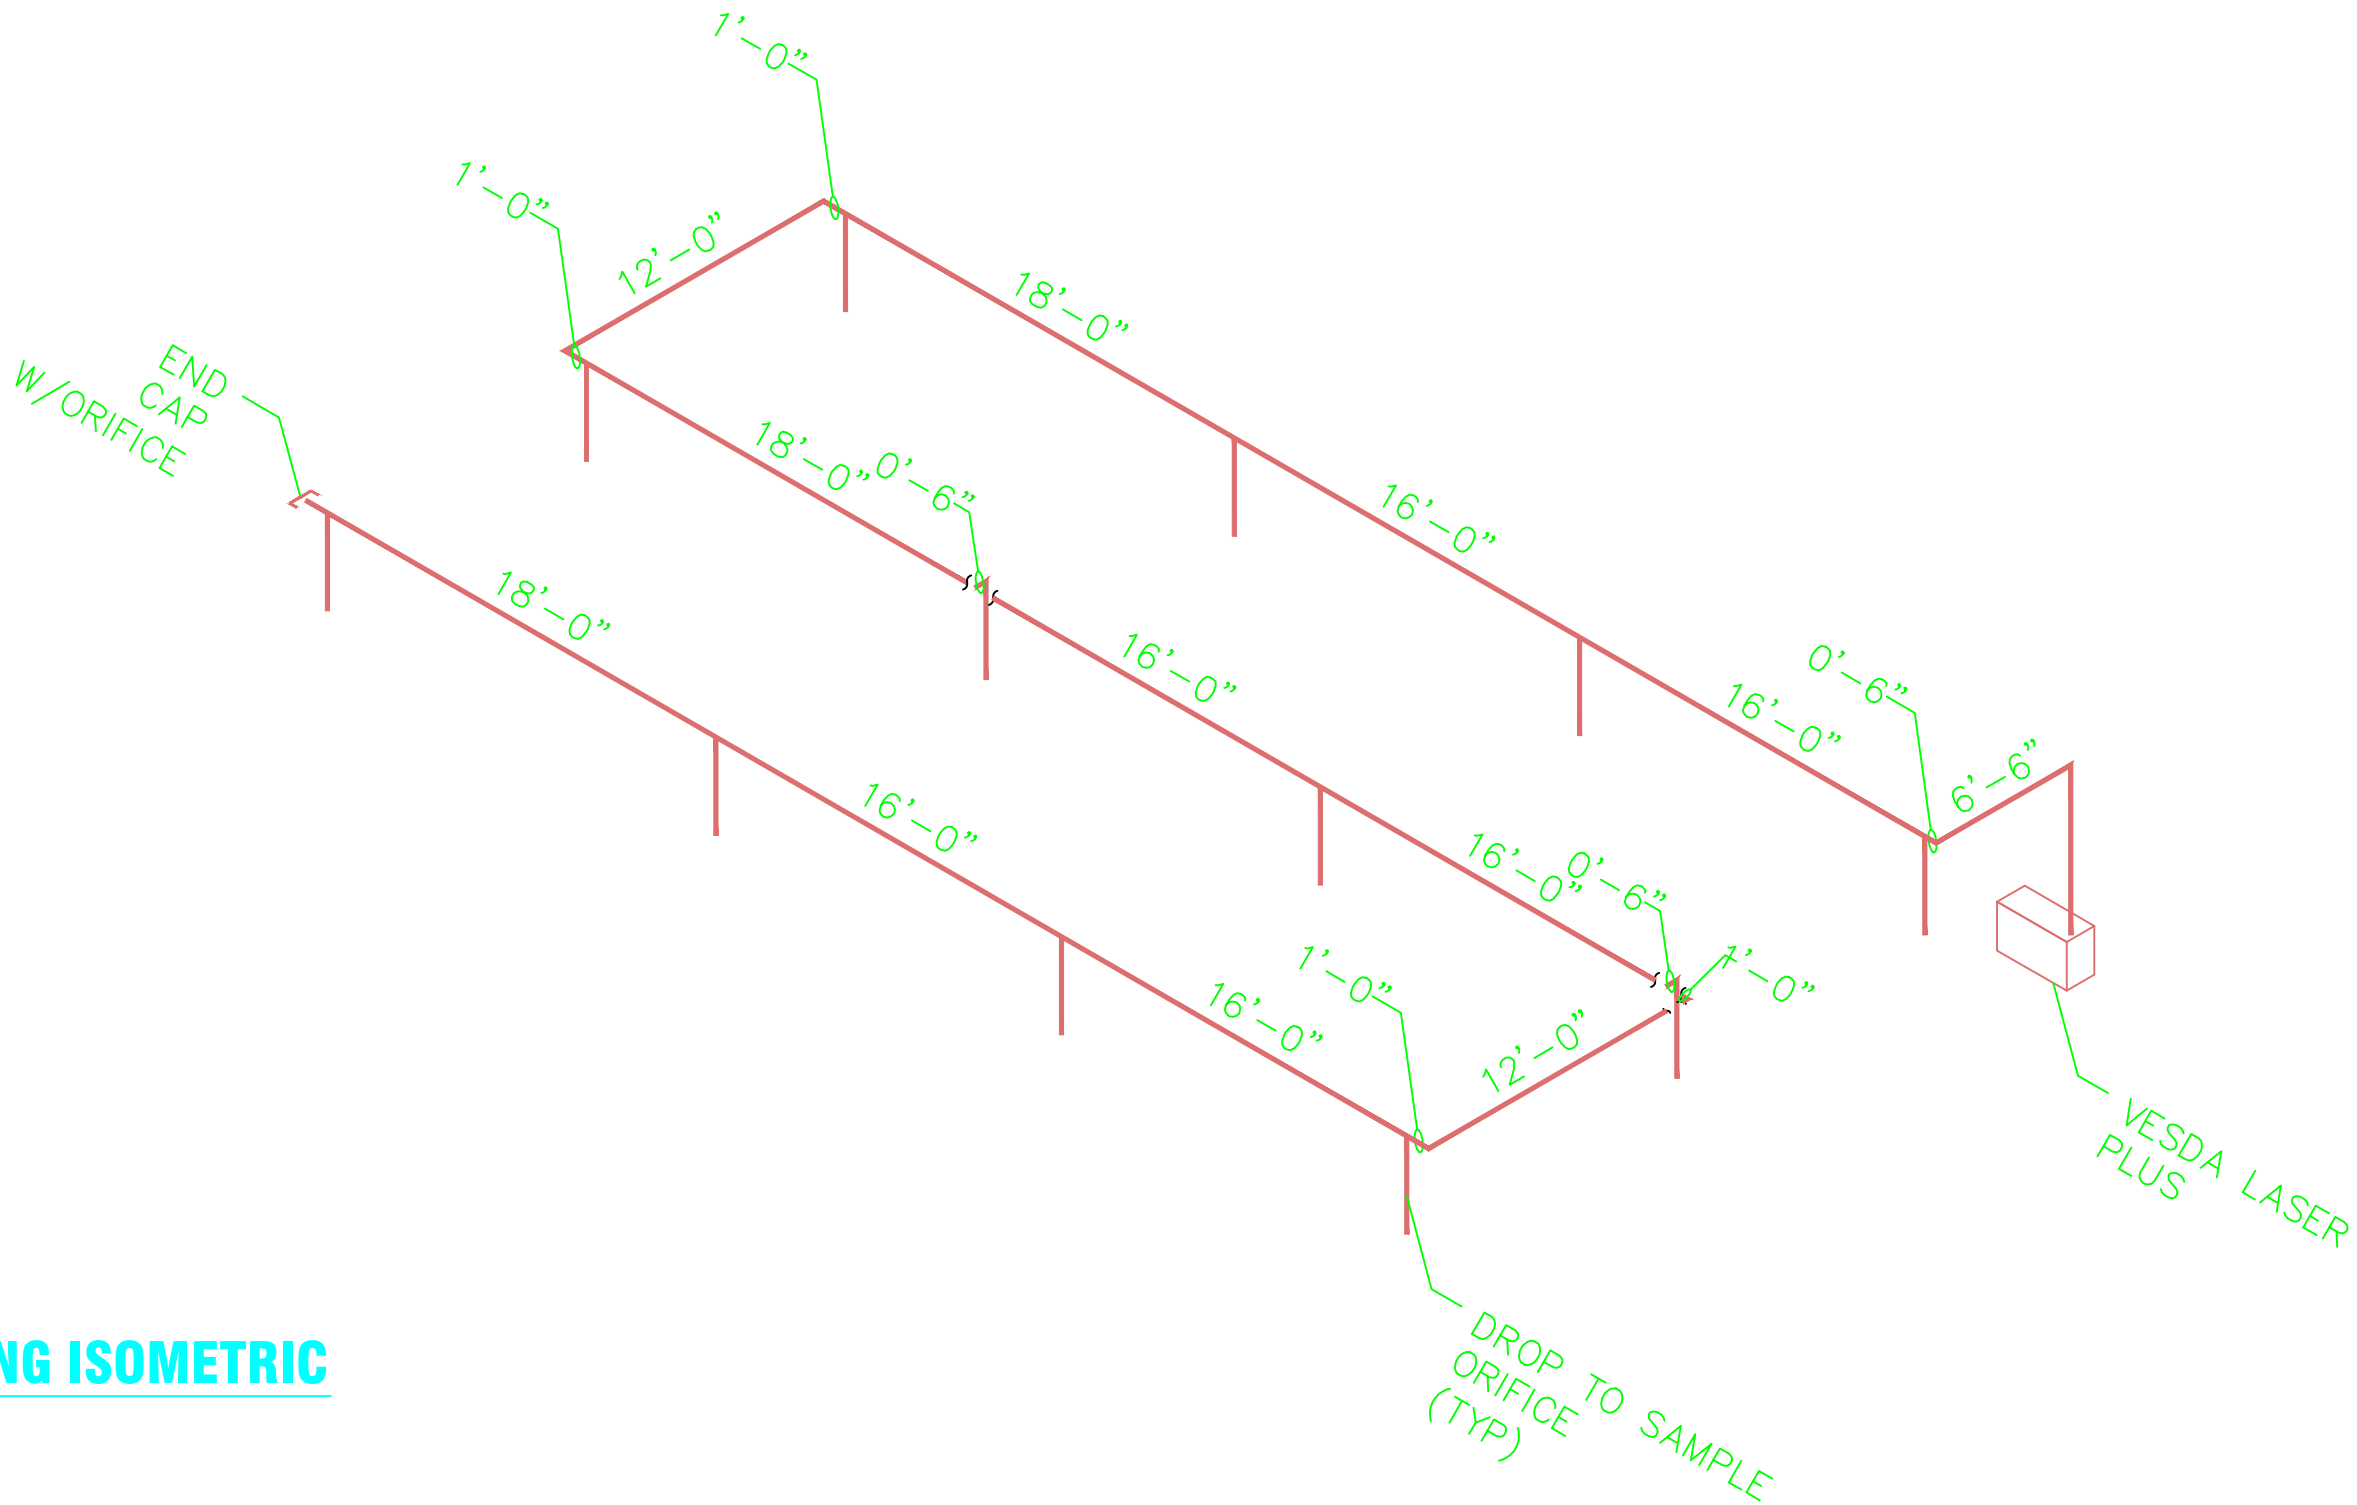

3 VESDA WIRING ARRANGEMENT
N.T.S

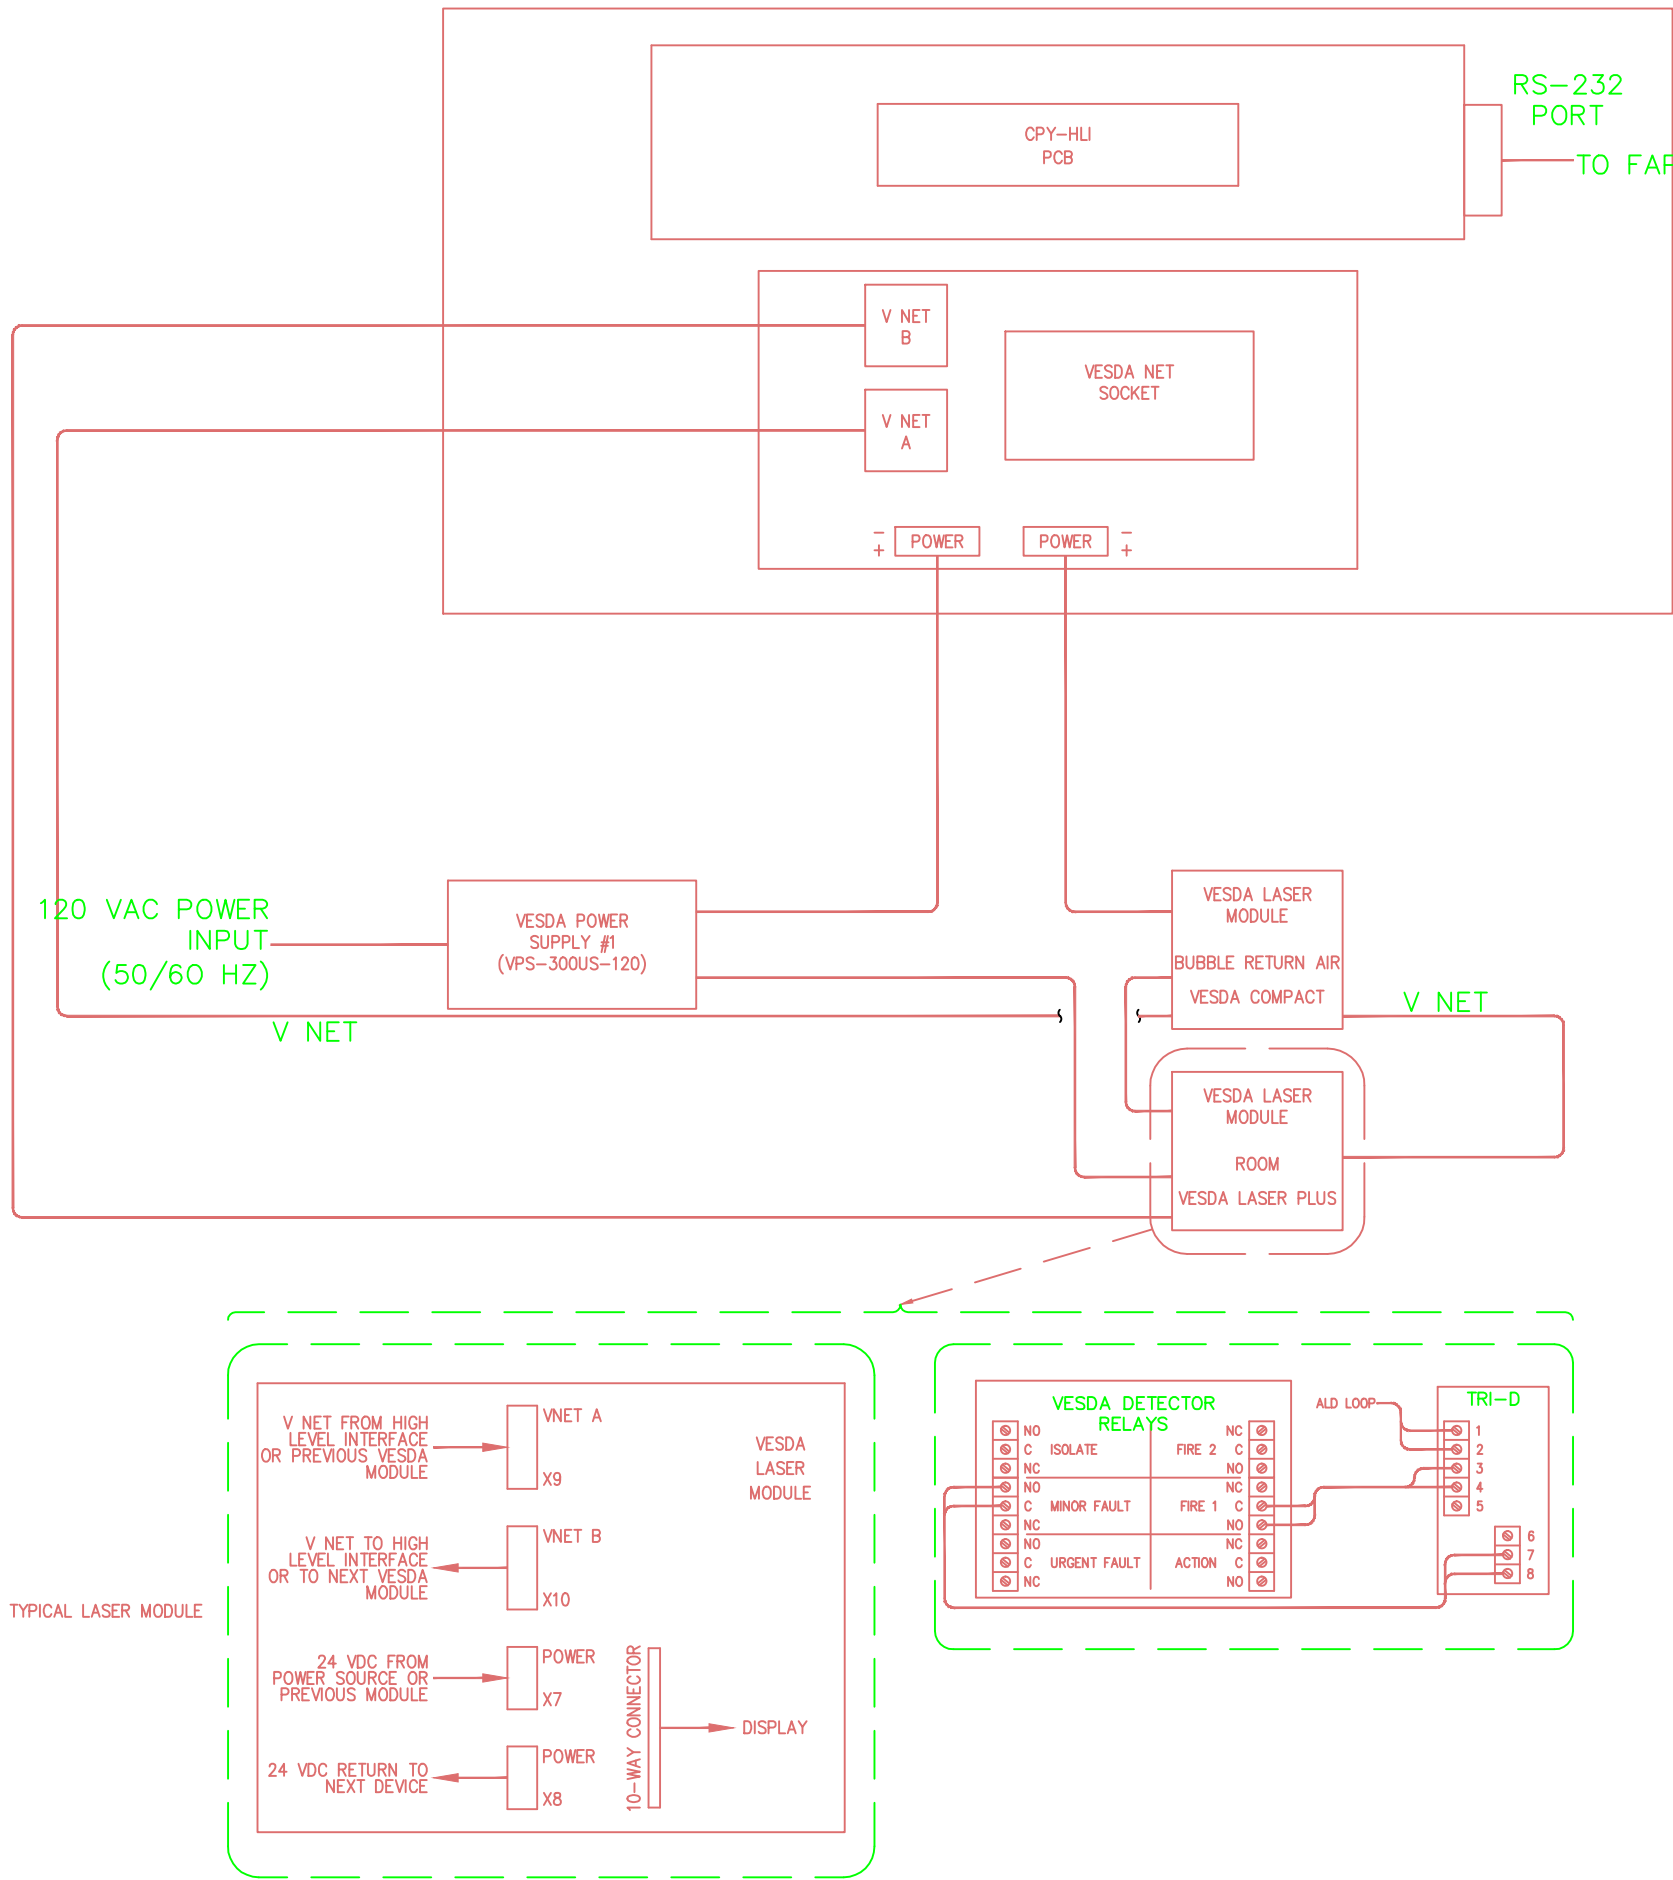

PROFESSIONAL SEAL (IF REVISION, APPLIES ONLY TO REVISED WORK)	ISSUE (PROGRESS, ESTIMATE, BID, CONSTRUCTION, CONFORMED, REVISION, RECORD)	AS BUILT				BLDG 86 FIRE ALARM				DRAWN BY	DSV	DATE	07/19/2013				
		—				ROOF PLAN, VESDA PIPING & WIRING				CHECKED BY	LDD		07/23/2013				
		07/19/2013								APPROVED BY	MCD		07/23/2013				
AS BUILT FROM A/E RECORD DWG		UNIVERSITY OF CALIFORNIA LAWRENCE BERKELEY NATIONAL LABORATORY FACILITIES DIVISION										SCALE	AS NOTED	DRAWING NO.	4B86E028_	SHEET	4
												PROJECT NO.: FM5500		4 OF 4			